

APPLICATION FOR PERMIT

SEWER—SEWAGE DISPOSAL

1

DIVISION OF BUILDING AND SAFETY

Department of County Engineer
County of Los Angeles

JOHN A. LAMBIE, COUNTY ENGINEER

CASSATT D. GRIFFIN, SUP'T OF BUILDING

FOR APPLICANT TO FILL IN

LEGAL DESCRIPTION	LOT NO. 56-A
BLOCK	TRACT 10759
SIZE OF LOT	175' x 120' NO. OF BLDGS. 1
USE OF BUILDINGS	DWELLING
CONTRACTOR	R.A. JOHNSON
ADDRESS	6248 PALA AVE
CITY	BELL TEL. NO. LD 89056
REGISTRATION NO.	137409 C42

NO.	DESCRIPTION OF WORK	FEE
1	HOUSE SEWER CONNECTING TO PUBLIC SEWER @ \$ 3.50	3 50
	SEPTIC TANK, SEEPAGE PIT OR PITS AND/OR DRAINFIELD @ \$ 3.00	
	OVERFLOW SEEPAGE PIT, DRAINFIELD EXTN., CESSPOOL, DRYWELL, MANHOLE @ \$ 2.00	
	HOUSE SEWER CONNECTING TO PRIVATE DISPOSAL SYSTEM @ \$ 1.00	
	CONNECT ADDITIONAL BLDG. OR WORK TO HOUSE SEWER @ \$ 1.00	
	ALTER, REPAIR OR ABANDON HOUSE SEWER OR DISPOSAL SYSTEM @ \$ 1.00	

OWNER'S AUTHORIZATION

PERMIT \$ 1 00
TOTAL FEE 4 50

I HAVE AT THIS DATE A CONTRACT WITH THE HEREIN NAMED CONTRACTOR TO CONNECT THE ABOVE DESCRIBED EXISTING DWELLING TO THE PUBLIC SEWER.

SIGNED THIS DAY OF 19

OWNER OR OWNERS AGENT

ADDRESS

I HEREBY ACKNOWLEDGE THAT I HAVE READ THIS APPLICATION AND STATE THAT THE ABOVE IS CORRECT AND AGREE TO COMPLY WITH ALL COUNTY ORDINANCES AND STATE LAWS REGULATING PLUMBING AND SEWERS.

I HEREBY CERTIFY THAT I AM PROPERLY REGISTERED AND/OR LICENSED AS REQUIRED BY LOS ANGELES COUNTY AND STATE OF CALIFORNIA OR THAT I AM THE LEGAL OWNER OF THE ABOVE DESCRIBED RESIDENTIAL PROPERTY.

SIGNATURE OF PERMITTEE

BUILDING ADDRESS	5310 FERN FIELD
LOCALITY	E.L.A.
NEAREST CROSS ST.	ATLANTIC
OWNER	FRANK MOTTOLA
MAIL ADDRESS	232 S. ATLANTIC
CITY	L.A. TEL. NO. AN 85778

DISTRICT NO.	GROUP	BK	MAP	PG
6	I		L	83

CONNECTION DATA

STATION	6759.5	DEPTH	5'
MANHOLE REFERENCE	34.5	N	UPPER LOWER

TYPE OF CONNECTION	LENGTH FROM M.L. TO P.L.
CURB P.L.	10'

CO. IMP. NO.	P. C. NO. JOB NO.
1081	

TRUNK PERMIT NO.	ROAD PERMIT NO.

STATE ENCROACHMENT PERMIT NO.

INDUSTRIAL WASTE APPROVAL

CHARGES

CONNECTION CHARGE FEE

REIMBURSEMENT FEE

APPROVALS

APPROVALS	DATE	INSPECTOR'S SIGNATURE
NEW HOUSE SEWER	10-16-57	Galleaga
CONNECT ADDITIONAL BUILDING OR WORK		
SEPTIC TANK, SEEP, PIT (S) AND/OR DRAINFIELD		
CESSPOOL <input type="checkbox"/> DRYWELL <input type="checkbox"/>		
ALTER, REPAIR, SEWER OR SEWAGE DISPOSAL SYSTEM		
DISCONNECT PLUG AND ABANDON HOUSE SEWER		
BACKFILL SEPTIC TANKS <input type="checkbox"/> SEEP, PIT (S) <input type="checkbox"/> CESSPOOLS <input type="checkbox"/>		

JOHN A. LAMBIE, COUNTY ENGINEER

VALIDATION

ROBERT A. WOOD, CHIEF PLBG. INSPECTOR

CK. M. O. CASH


10677005 OCT 16 4 4.50

E. Bacon

FOR DEPARTMENT USE

REQUIRED INFORMATION

1. INDICATE ALL BUILDINGS ON PROPERTY.
2. INDICATE AND DIMENSION SEWAGE DISPOSAL SYSTEM WITH TIE DISTANCES TO BUILDINGS AND PROPERTY LINES.
3. INDICATE SIZE OF SEPTIC TANK—DEPTH OF SEEPAGE PIT(S)—SIZE OF CESSPOOL(S).
4. INDICATE NORTH DIRECTION ON PLOT.
5. INDICATE BOTH STREETS IF CORNER.

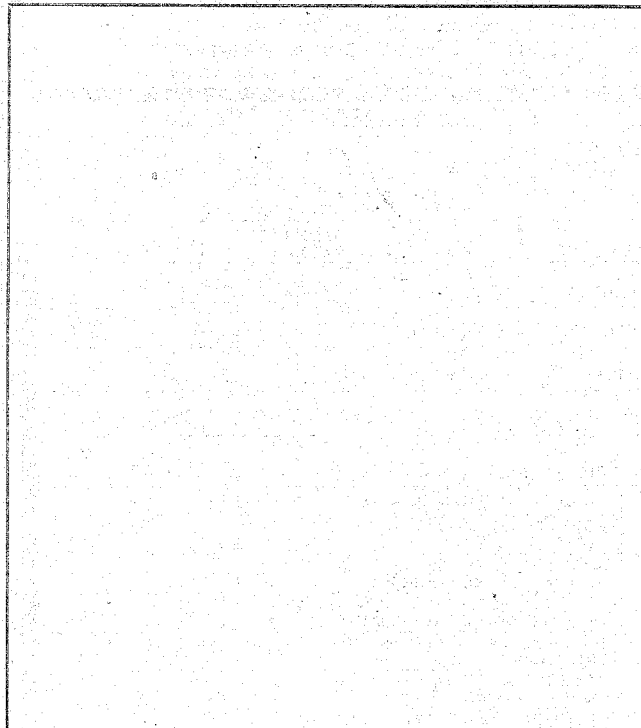

ST. ALLEY R/W

FIELD NOTES